

WISCONSIN AVE.
ENTRANCE

NANCY FOREMAN DESIGN, INC. T/A NFD
DOES NOT WARRANT THE ACCURACY OF
ANY DIMENSIONS SET FORTH HERE ON.
CONTRACTOR IS RESPONSIBLE FOR VERIFYING
ALL SITE CONDITIONS TO HOLD
FIELD DIMENSIONS WHERE APPLICABLE.
SHOULD THERE BE ANY DISCREPANCIES
WITH THIS CONSTRUCTION DRAWING
PACKAGE, NFD SHOULD BE NOTIFIED IMMEDIATELY FOR RESPONSE. IF THE CONTRACTOR
WISHES TO MAKE ANY CHANGES ON HIS OWN WITHOUT NOTIFYING NFD, HE IS RESPONSIBLE FOR SAME.
NFD DOES NOT PROVIDE ARCHITECTURAL,
STRUCTURAL, ENGINEERING OR MECHANICAL SERVICES IF SUCH SERVICES ARE REQUIRED BY THIS DRAWING PACKAGE. A LICENSED PROFESSIONAL MUST BE OBTAINED AND PREPARED THIS DRAWING PACKAGE AS A PRACTICAL SOLUTION TO INTERIOR DESIGN PROBLEMS. IT IS NOT INTENDED FOR ARCHITECTURAL, ENGINEERING OR CONSTRUCTION USE. ANY CEILING, ELECTRICAL, KITCHEN, BATHROOM OR LIKE PLAN OR SPECIFICATION IS PREPARED TO SHOW ONLY LOCATION OF OUTLETS, FIXTURES, VENTS, ETC. AND THE TYPE OF FIXTURES AND EQUIPMENT. THIS DRAWING PACKAGE IS THE PROPERTY OF NFD. UNAUTHORIZED USE OF THESE DOCUMENTS IS PROHIBITED.


UPPER LEVEL
5410 WISCONSIN AVENUE
CHEVY CHASE, MARYLAND 20815

AS-BUILT PLAN
1,414 SQUARE FEET

DATE: 13 SEPT. 06
SCALE: N.T.S.
JOB NO: CR450
DESIGN BY: CKH
DRAWN BY: CKH
CHECKED BY: CKH

REVISIONS

NFD
NANCY FOREMAN DESIGN, INC.
BALTIMORE RICHMOND
16 GREENMEADOW DRIVE
TIMONIUM, MARYLAND 21083
410/561-0561 804/747-9559

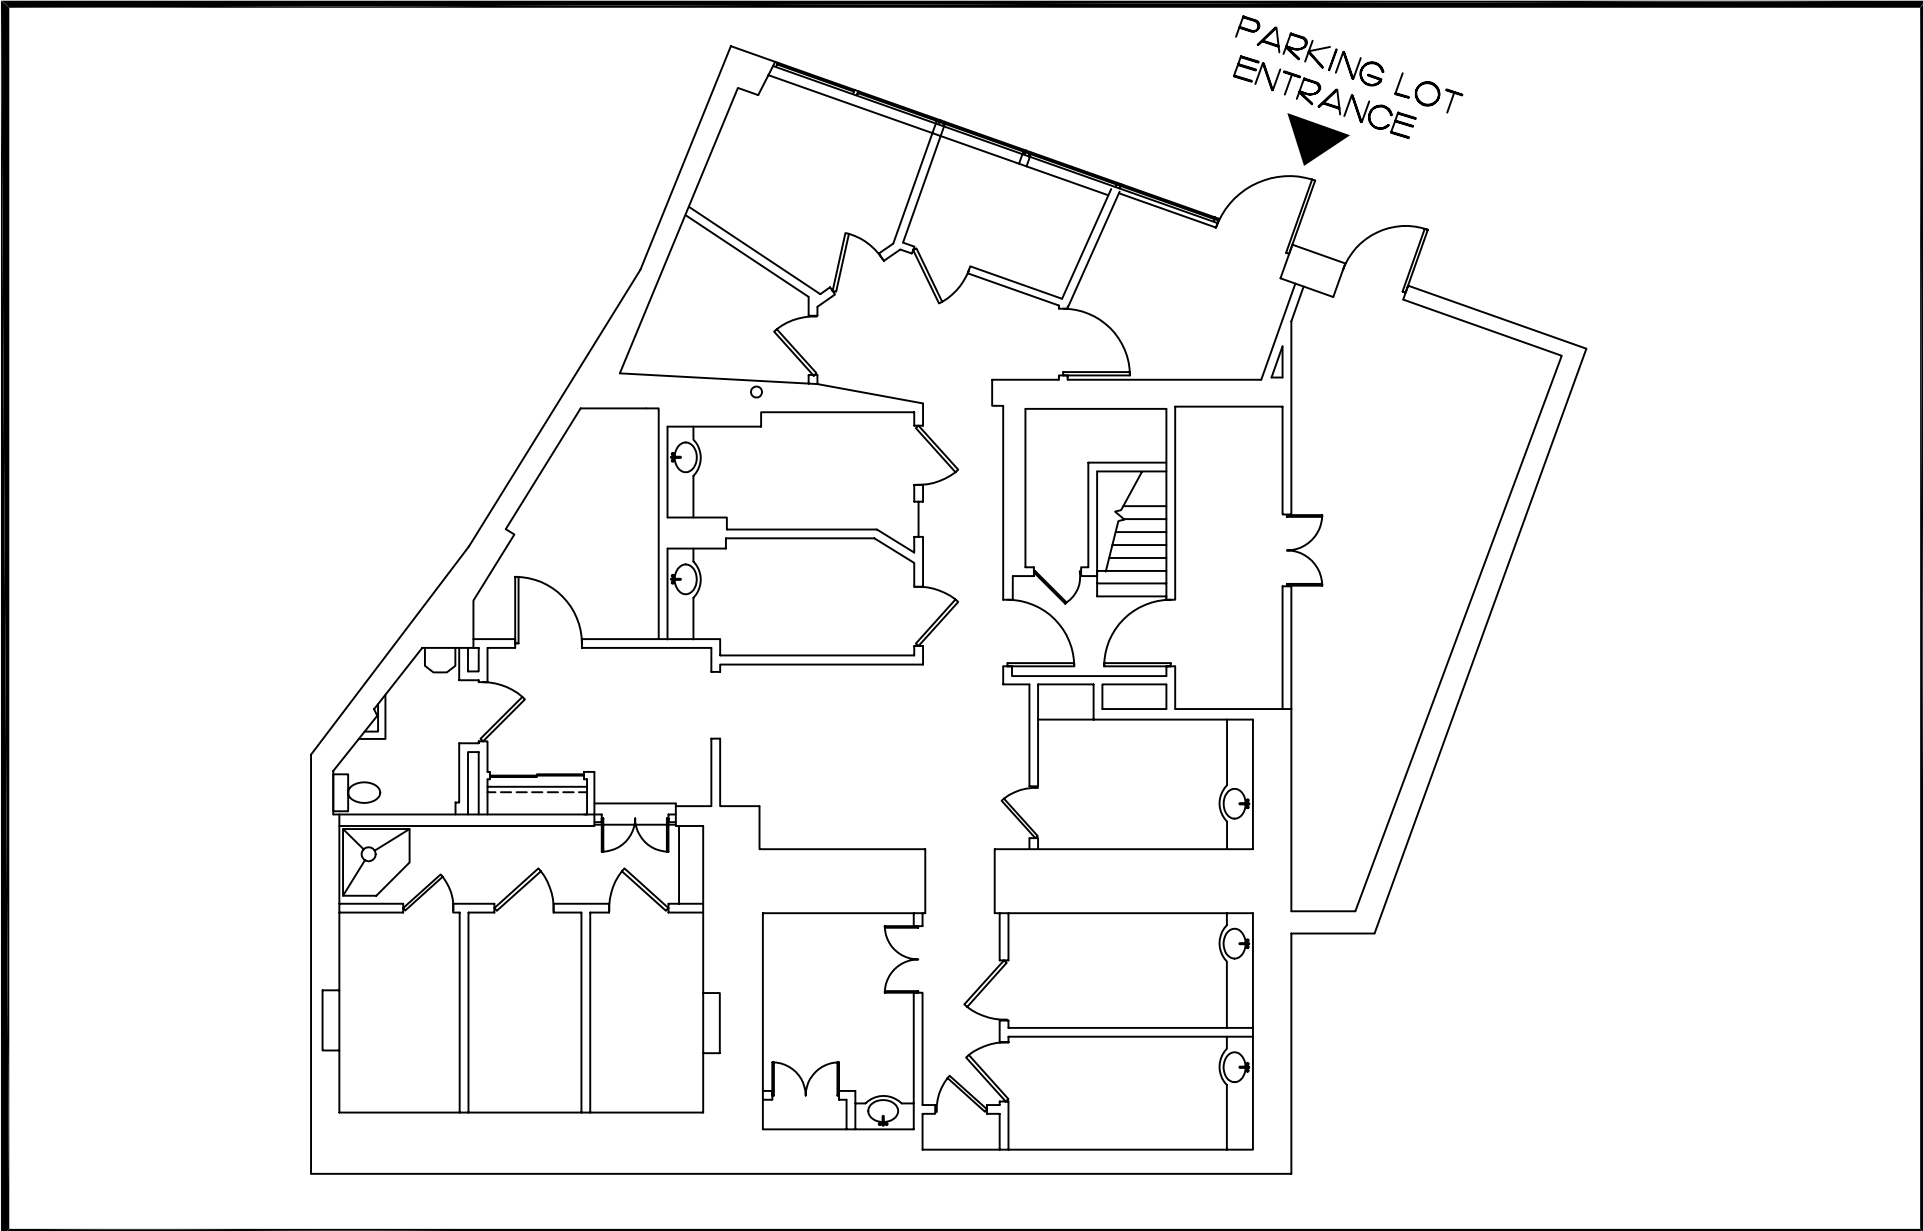

NANCY FOREMAN DESIGN, INC. VIA NFD
 DOES NOT WARRANT THE ACCURACY OF
 ANY DIMENSIONS SET FORTH HERE ON.
 CONTRACTOR IS RESPONSIBLE FOR VERIFYING
 ALL SITE CONDITIONS TO HOLD
 FIELD DIMENSIONS WHERE APPLICABLE.
 SHOULD THERE BE ANY DISCREPANCIES
 WITH THIS CONSTRUCTION DRAWING
 PACKAGE, NFD SHOULD BE NOTIFIED IMMEDIATELY
 FOR RESPONSE. IF THE CONTRACTOR
 CHANGES ON HIS OWN WITHOUT NOTIFYING
 NFD, HE IS RESPONSIBLE FOR SAME.
 NFD DOES NOT PROVIDE ARCHITECTURAL,
 STRUCTURAL, ENGINEERING OR
 MECHANICAL SERVICES IF SUCH SERVICES

WORKS ARE REQUIRED BY THIS DRAWING
 PACKAGE. A LICENSED PROFESSIONAL
 MUST BE OBTAINED. NFD PREPARED THIS
 DRAWING PACKAGE AS A PRACTICAL
 SOLUTION TO INTERIOR DESIGN PROBLEMS.
 IT IS NOT INTENDED FOR ARCHITECTURAL,
 ENGINEERING OR CONSTRUCTION USES.
 ANY CHANGES ELECTRICAL, KITCHEN,
 BATHROOM OR LIKE TRADES SUBJECT TO MAKE ANY
 TUBES, VENTS, ETC. AND THE TYPE OF
 PORTABLE AND EQUIPMENT. THIS DRAWING
 PACKAGE IS THE PROPERTY OF NFD.
 UNAUTHORIZED USE OF THESE DOCUMENTS IS PROHIBITED.

LOWER LEVEL
 5410 WISCONSIN AVENUE
 CHEVY CHASE, MARYLAND 20815

AS-BUILT PLAN
 2,042 SQUARE FEET

DATE: 13 SEPT. 06
 SCALE: N.T.S.
 JOB NO: CR450
 DESIGN BY: CKH
 DRAWN BY: CKH
 CHECKED BY: CKH

REVISIONS

NFD
 NANCY FOREMAN DESIGN, INC.
 BALTIMORE RICHMOND
 16 GREENMEADOW DRIVE
 TIMONIUM, MARYLAND 21083
 410/561-0561 804/747-9559